


Suite 355

± 4,217 SF




DETAILS:

- 2 Conference Rooms
- Private Office
- Kitchen
- Reception
- Open Office Area

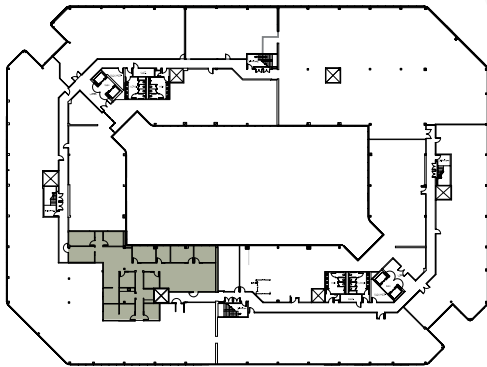

HYPOTHETICAL FLOORPLAN

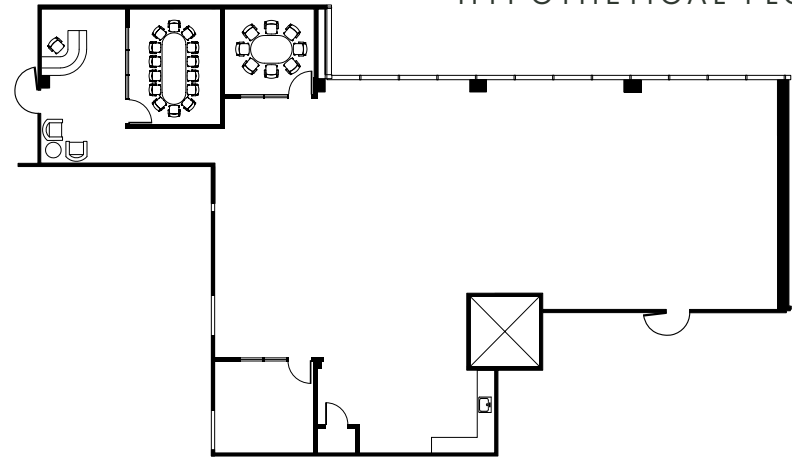

AS BUILT FLOORPLAN

