

399 N Whisman Road  
Mountain View, CA

# theQuad

mountain view

BUILDING FIVE  
FLOOR PLANS

±64,624 RSF



# theQuad

mountain view


399 N WHISMAN RD.

## FIRST FLOOR

AS-BUILT PLAN

32,223 SF

- ▶ 16 Office/Huddle Rooms
- ▶ 7 Phone Rooms
- ▶ 5 Conference Rooms

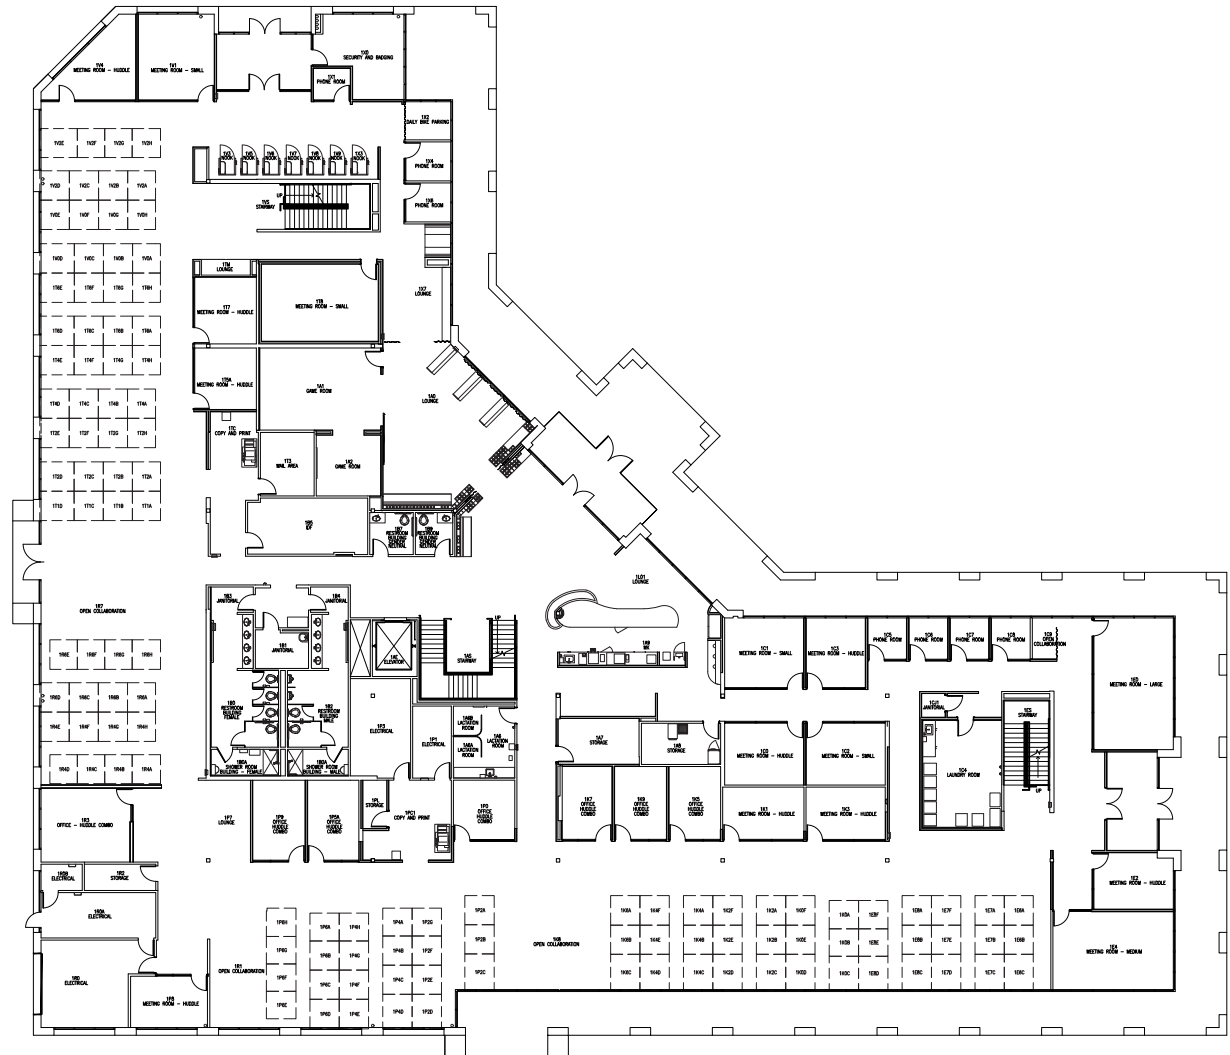

©2026 Cushman & Wakefield. All rights reserved. The information contained in this communication is strictly confidential. This information has been obtained from sources believed to be reliable but has not been verified. NO WARRANTY OR REPRESENTATION, EXPRESS OR IMPLIED, IS MADE AS TO THE CONDITION OF THE PROPERTY (OR PROPERTIES) REFERENCED HEREIN OR AS TO THE ACCURACY OR COMPLETENESS OF THE INFORMATION CONTAINED HEREIN, AND SAME IS SUBMITTED SUBJECT TO ERRORS, OMISSIONS, CHANGE OF PRICE, RENTAL OR OTHER CONDITIONS, WITHDRAWAL WITHOUT NOTICE, AND TO ANY SPECIAL LISTING CONDITIONS IMPOSED BY THE PROPERTY OWNER(S). ANY PROJECTIONS, OPINIONS OR ESTIMATES ARE SUBJECT TO UNCERTAINTY AND DO NOT SIGNIFY CURRENT OR FUTURE PROPERTY PERFORMANCE.

# theQuad

mountain view


399 N WHISMAN RD.

## FIRST FLOOR

*HYPOTHETICAL  
FURNITURE PLAN*

**32,223 SF**

- ▶ 16 Office/Huddle Rooms
- ▶ 14 Phone Rooms
- ▶ 6 Conference Rooms
- ▶ 175 Workstations/Desks

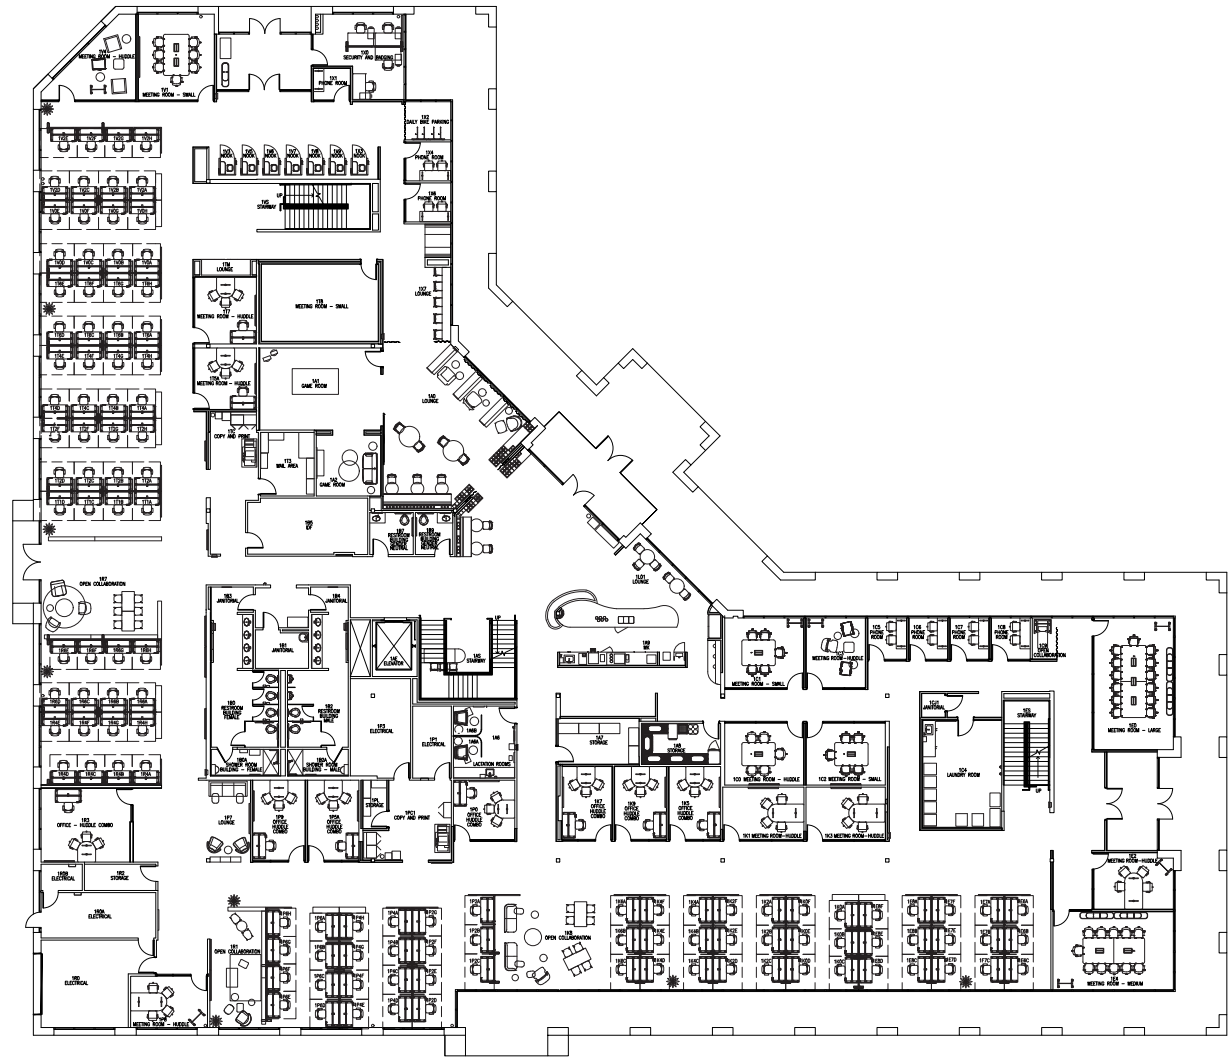

©2026 Cushman & Wakefield. All rights reserved. The information contained in this communication is strictly confidential. This information has been obtained from sources believed to be reliable but has not been verified. NO WARRANTY OR REPRESENTATION, EXPRESS OR IMPLIED, IS MADE AS TO THE CONDITION OF THE PROPERTY (OR PROPERTIES) REFERENCED HEREIN OR AS TO THE ACCURACY OR COMPLETENESS OF THE INFORMATION CONTAINED HEREIN, AND SAME IS SUBMITTED SUBJECT TO ERRORS, OMISSIONS, CHANGE OF PRICE, RENTAL OR OTHER CONDITIONS, WITHDRAWAL WITHOUT NOTICE, AND TO ANY SPECIAL LISTING CONDITIONS IMPOSED BY THE PROPERTY OWNER(S). ANY PROJECTIONS, OPINIONS OR ESTIMATES ARE SUBJECT TO UNCERTAINTY AND DO NOT SIGNIFY CURRENT OR FUTURE PROPERTY PERFORMANCE.

mountain view

399 N WHISMAN RD.

## SECOND FLOOR

**AS-BUILT PLAN**

**32,401 SF**

- ▶ 22 Office/Huddle Rooms
- ▶ 19 Phone Rooms
- ▶ 11 Conference Rooms



©2026 Cushman & Wakefield. All rights reserved. The information contained in this communication is strictly confidential. This information has been obtained from sources believed to be reliable but has not been verified. NO WARRANTY OR REPRESENTATION, EXPRESS OR IMPLIED, IS MADE AS TO THE CONDITION OF THE PROPERTY (OR PROPERTIES) REFERENCED HEREIN OR AS TO THE ACCURACY OR COMPLETENESS OF THE INFORMATION CONTAINED HEREIN, AND SAME IS SUBMITTED SUBJECT TO ERRORS, OMISSIONS, CHANGE OF PRICE, RENTAL OR OTHER CONDITIONS, WITHDRAWAL WITHOUT NOTICE, AND TO ANY SPECIAL LISTING CONDITIONS IMPOSED BY THE PROPERTY OWNER(S). ANY PROJECTIONS, OPINIONS OR ESTIMATES ARE SUBJECT TO UNCERTAINTY AND DO NOT SIGNIFY CURRENT OR FUTURE PROPERTY PERFORMANCE.

# theQuad


mountain view

399 N WHISMAN RD.  
**SECOND FLOOR**

*HYPOTHETICAL  
FURNITURE PLAN*

**32,401 SF**

- ▶ 23 Office/Huddle Rooms
- ▶ 19 Phone Rooms
- ▶ 10 Conference Rooms
- ▶ 255 Workstations/Desks

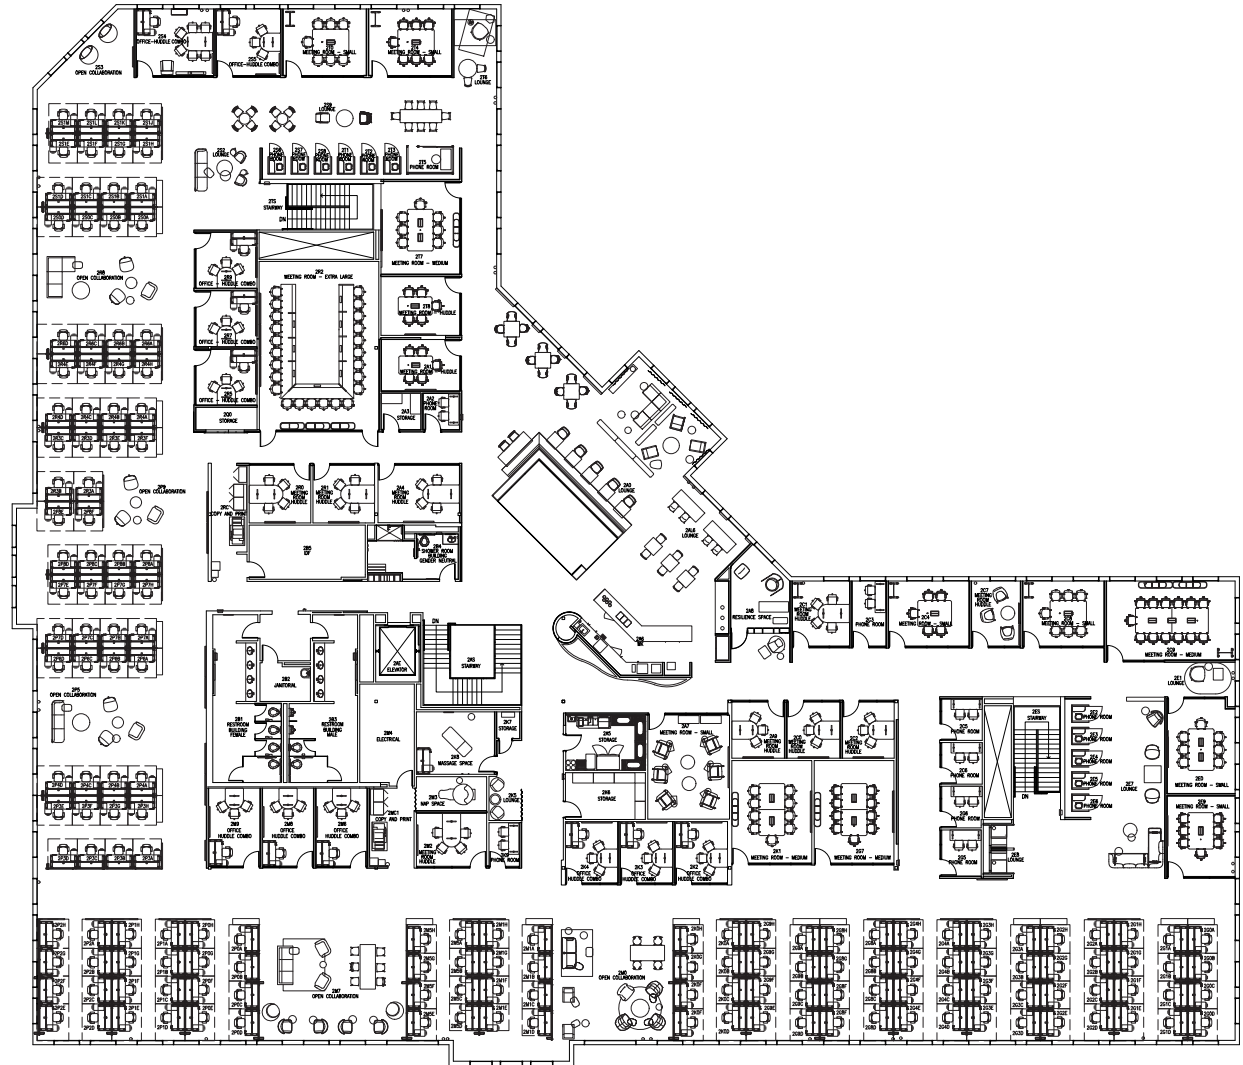

©2026 Cushman & Wakefield. All rights reserved. The information contained in this communication is strictly confidential. This information has been obtained from sources believed to be reliable but has not been verified. NO WARRANTY OR REPRESENTATION, EXPRESS OR IMPLIED, IS MADE AS TO THE CONDITION OF THE PROPERTY (OR PROPERTIES) REFERENCED HEREIN OR AS TO THE ACCURACY OR COMPLETENESS OF THE INFORMATION CONTAINED HEREIN, AND SAME IS SUBMITTED SUBJECT TO ERRORS, OMISSIONS, CHANGE OF PRICE, RENTAL OR OTHER CONDITIONS, WITHDRAWAL WITHOUT NOTICE, AND TO ANY SPECIAL LISTING CONDITIONS IMPOSED BY THE PROPERTY OWNER(S). ANY PROJECTIONS, OPINIONS OR ESTIMATES ARE SUBJECT TO UNCERTAINTY AND DO NOT SIGNIFY CURRENT OR FUTURE PROPERTY PERFORMANCE.

464-666-468 Ellis St. & 369-379-389-399 N Whisman Rd.  
**Mountain View, CA**

# theQuad

mountain view

*For More Information, Please Contact:*

**ERIK HALLGRIMSON**

+1 408 615 3435

[erik.hallgrimson@cushwake.com](mailto:erik.hallgrimson@cushwake.com)

Lic #01274540

**BRANDON BAIN**

+1 408 615 3416

[brandon.bain@cushwake.com](mailto:brandon.bain@cushwake.com)

CA Lic. #02089731

**KATE MYERS**

+1 408 502 0196

[kate.myers@cushwake.com](mailto:kate.myers@cushwake.com)

CA Lic. #02253804

